

## ADDENDUM NO. 02

March 16, 2020

### **SYCAMORE CANYON SCHOOL – LEARNING RESOURCE CENTER (LRC) – 04-118743**

SANTEE SCHOOL DISTRICT

Item No. 1	Specifications
AD2	Division 1

- A. Add Specification Section 01 91 13 General Commissioning Requirements, per the attached AD2-01 91 13.

Item No. 2	Drawings
AD2	Sheet A2.1

- A. Revise sheet A2.1 Enlarged Floor Plan- Dimension, to show relocation of door 8 at Electrical Room 8, per AD2-A2.1

Item No. 3	Drawings
AD2	Sheet E1.1

- A. Revise sheet E1.1 to show underground electrical utilities stubbed out at "Future Classroom Building", per AD2-E1.1.

Item No. 4	Drawings
AD2	Sheet E2.1

- A. Revise sheet E2.1 to show additional fixture callouts at Classroom 10, per AD2-E2.1

Item No. 5	Drawings
AD2	Sheet E3.1

- A. Revise sheet E3.1, detail 2 to show reconfigured Electrical Room 8, per AD2-E3.1.

Item No. 6	Drawings
AD2	Sheet E5.0

A. Revise sheet E5.0 to show replacement of remote annunciator, per AD2-E5.0

Item No. 7	Drawings
AD2	Sheet E5.2

A. Revise sheet E5.2 to show new annunciator, per AD2-E5.2

Item No. 8	Drawings
AD2	Sheet E5.3

A. Revise sheet E5.3 to show revised riser diagram, per AD2-E5.3

Item No. 9	Drawings
AD2	Sheet E7.1

A. Revise sheet E7.1, detail 1 one-line diagram to updated panel 'L1' and panel 'L2', per AD2-E7.1.

Item No. 10	Drawings
AD2	Sheet E9.1

A. Revise sheet E9.1 to show updated Panel 'L1' schedule, per AD2-E9.1-1.

B. Revise sheet E9.1 to show updated Panel 'L2' schedule, per AD2-E9.1-2.


## END OF ADDENDUM NUMBER 02

**StudioWC**

Robert D. Webb, AIA, Architect, Senior Vice President

**ATTACHMENTS:**

Specifications 8.5" x 11"  
AD2-01 91 13

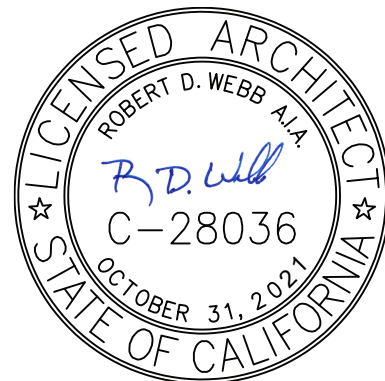

Drawings 8.5" x 11"

AD2-A2.1 Enlarged Floor Plan- Dimension

AD2-E3.1 Level 1 Floor Plan- Power

Drawings 11" x 17"

AD2-E1.1 Overall Site Plan

AD2-E2.1 Level 1 Floor Plan- Lighting

AD2-E5.0 Fire Alarm Site Plan

AD2-E5.2 Fire Alarm Schedule

AD2-E5.3 Fire Alarm Riser and Calculations

AD2-E7.1 One-Line Diagram

AD2-E9.1-1 Panel Schedules

AD2-E9.1-2 Panel Schedules

**SECTION AD2- 01 91 13**

**GENERAL COMMISSIONING REQUIREMENTS**

PART 1 - GENERAL

1.1 RELATED DOCUMENTS

- A. Drawings and general provisions of the Contract, including General and Supplementary Conditions and other Division 01 Specification Sections, apply to this Section.
- B. District's Project Requirements and Basis-of-Design documentation are included by reference for information only.

1.2 SUMMARY

A. Section Includes:

1. General requirements for coordinating and scheduling commissioning.
2. Commissioning Team duties.
3. Commissioning meetings.
4. Commissioning scheduling.
5. Test equipment, instrumentation, and tools for commissioning.
6. Construction verification.
7. Functional performance testing.
8. Commissioning tests and commissioning test demonstration.
9. Commissioning Report.

B. Related Requirements:

1. Section 01 33 00 "Submittal Procedures" for submittal procedures requirements for commissioning.
2. Section 01 77 00 "Closeout Procedures" for certificate of Construction Phase Commissioning Completion submittal requirements.
3. Section 01 78 23 "Operation and Maintenance Data" for preliminary operation and maintenance data submittal.
4. Section 23 08 00 "Commissioning of HVAC" for technical commissioning requirements for HVAC.

1.3 DEFINITIONS

- A. Acceptance Criteria: Threshold of acceptable work quality or performance specified for a commissioning activity, including, but not limited to, construction checklists, performance tests, performance test demonstrations, commissioning tests and commissioning test demonstrations.
- B. Basis-of-Design: A detailed description of building Design criteria, parameters, set-points, concepts, decisions and selections used to meet the District's Project Requirements that serves as a basis for review, approval and documentation of the Design process used for all building systems.

**SYCAMORE CANYON SCHOOL  
LIBRARY RESOURCE CENTER  
SANTEE SCHOOL DISTRICT**

- C. Commissioning Agent: A District appointed entity that plans and coordinates all activities that implement commissioning as outlined by District's Basis of Design.
- D. Commissioning Plan: A document, prepared by Commissioning Agent, that outlines the organization, schedule, allocation of resources, and documentation requirements of commissioning.
- E. Commissioning Report: A document, prepared by the Commissioning Agent, that records the activities and results of the Commissioning process.
- F. Commissioning: The process of ensuring that systems are designed, installed, functionally tested and performing in conformity with the District's Requirements and that the District has received complete equipment/systems documentation and training.
- G. Construction Verification: A quality control verification process performed by the installer as building assemblies, components, equipment and systems are being installed that documents that the materials, installation procedures, interfaces with other trades, start-up, testing and operations are correct, complete, in compliance with Contract Documents and manufacturer's recommendations and are ready for Functional Performance Testing.
- H. District's Project Requirements: A narrative of the program, use and functional requirements of the building with a description of the Project goals and criteria in general categories (e.g.: flexibility of use, ease of maintenance, future expansion, etc.) and specific categories (e.g.: specialized environments, specific sustainable features, quality of materials, etc.).
- I. Functional Performance Tests: Contractor testing of installed building assemblies, components, equipment, systems and interfaces which confirms correct performance through all operating modes and compliance with Contract Documents, manufacturer's recommendations and the District's Project Requirements.
- J. Retro-Commissioning: A systematic process for improving and optimizing a building's operations and supporting those improvements with enhanced documentation and operator training.
- K. Test: Performance tests, performance test demonstrations, commissioning tests, and commissioning test demonstrations.

**1.4 ABBREVIATIONS**

- A. The following abbreviations are used in this Section:
  - 1. A/E Architect / Engineer.
  - 2. BAS: Building Automation System.
  - 3. Cx: Commissioning.
  - 4. CxA: Commissioning Agent.
  - 5. DPR: District's Project Requirements.
  - 6. FPT: Functional Performance Tests.
  - 7. O&M: Operations and Maintenance.
  - 8. PI: Project Inspector.
  - 9. PPO: Physical Plant Operations
  - 10. P/T: Pressure / Temperature.
  - 11. TAB: Testing, Adjusting, and Balancing.

1.5 COMMISSIONING TEAM DUTIES

Cx TASK	Provided By					Provided To					Planning	Design	Construction	Turnover	Operation	
	DISTRICT	PI	A/E	CxA	CONTRACTOR	PPO	PI	A/E	CxA	CONTRACTOR						
District's Project Requirements				X		X	X	X		X		PPO Narrative	Update	Update	Update, Include in Cx Report	
	X	X	X								X	Review Comments on PPO	Additional Comments on PPO	Additional Comments on PPO	Additional Comments on PPO	
Basis of Design			X			X	X			X		Basis of Design	Update	Update	Update	
	X	X		X				X				Review Comments	Additional Comments	Additional Comments	Additional Comments	
				X		X	X	X		X					Include in Cx Report	
Cx Plan				X		X	X	X		X		Cx Plan	Update	Update	Update, Include in Cx Report	Update, Include in Cx Report
	X	X			X					X		Review Comments	Additional Comments	Additional Comments	Additional Comments	Additional Comments
Construction Verification Checklists and Checklist Tracking Report					X	X				X				Edit and Develop		
					X	X				X				Perform and Submit as Work is Installed	Include in O&M Manuals	
	X			X							X			Review Comments		
Functional Performance Tests and FPT Tracking Report					X	X				X				Develop & Update Test Forms, Schedule and Direct Tests	Include in Cx Report	
					X	X				X				Perform and Submit		
	X			X							X			Review Comments		
Cx Report				X	X	X	X		X						Draft Report	Final Report
Cx Issues, Site Visit and Closeout				X	X	X	X		X		Cx Issues, Site Visit & Closeout Log	Update	Update	Update		

**SYCAMORE CANYON SCHOOL  
LIBRARY RESOURCE CENTER  
SANTEE SCHOOL DISTRICT**

Cx TASK Items Log	Provided By					Provided To					Planning	Design	Construction	Turnover	Operation
	DISTRICT	PI	A/E	CxA	CONTRACTOR	PPO	PI	A/E	CxA	CONTRACTOR					
					X				X				Actions Taken	Actions Taken	
PPO Training					X	X	X	X	X				O&M Data, Training Plan and Training		
	X		X							X			Evaluate O&M Data & Training		

1.6 INFORMATIONAL SUBMITTALS

- A. Comply with requirements in Section 01 33 00 "Submittal Procedures" for submittal procedures general requirements for commissioning.
- B. Lists:
  - 1. Construction Verification List.
    - a. Select appropriate lists from Appendix A.
  - 2. Function Performance Tests List.
    - a. Select appropriate lists from Appendix C.
- C. Forms:
  - 1. Construct Verification Tracking Report.
    - a. See Appendix B.
  - 2. Functional Performance Test Tracking Report.
    - a. See Appendix D.

PART 2 - PRODUCTS

2.1 TEST EQUIPMENT, INSTRUMENTATION, AND TOOLS

- A. Provide equipment required to perform startup, checkout and testing. Provide equipment that has been calibrated per the manufacturer's recommendations within the past year.

**PART 3 - EXECUTION**

**3.1 COMMISSIONING PLAN**

- A. Assist District's Commissioning Agent in development of a complete commissioning plan detailing the following information at a minimum:
  - 1. Contact information for key members of commissioning team.
  - 2. Description of procedures to be utilized for each commissioning task.
  - 3. List of commissioning systems and associated equipment.
  - 4. Functional Performance Test sampling approach to be utilized for repeat equipment items.
  - 5. List of responsibilities for each party involved in the commissioning process.
  - 6. Commissioning milestones and schedule.
  
- B. Commissioning Meetings:
  - 1. Attend commissioning meetings with involved subcontractors and other personnel requested by CxA. Each party is responsible for providing a review of Project progress, commissioning issues and scheduling for future commissioning tasks.
  
- C. Communication:
  - 1. Relay communications resulting from or in relation to commissioning activities directly to the responsible party whenever possible, with copies to District Construction Manager and Project Inspector.
  
- D. Responsibilities:
  - 1. All parties are to follow the Commissioning Plan and are responsible for commissioning activities as outlined in Article "Commissioning Team Duties."
  
- E. Scheduling:
  - 1. Provide CxA and involved subcontractors with a copy of the Project Schedule and regular monthly updates. CxA will provide Contractor with a detailed schedule of commissioning tasks for incorporation into project schedule.
  
- F. Construction Verification:
  - 1. The purpose of the Construction Verification List is to have a formal means of providing individual workers the key criteria for a successful installation and to easily track construction progress.
  - 2. Notify CxA five days prior to construction verification so that CxA may witness, as deemed necessary, each assembly, component, equipment, system start up and testing.
  - 3. If CxA identifies more than a 10 percent discrepancy rate, revalidate all items covered by that checklist and resubmit new checklists.
  
- G. Functional Performance Testing:
  - 1. Assist CxA in establishing a schedule for Functional Performance Testing.
  - 2. Ensure all subcontractors involved with specific assemblies, components, equipment, systems and interfaces have qualified installers and technicians present at the same time working together to perform testing and demonstrate correct performance through all



**SYCAMORE CANYON SCHOOL  
LIBRARY RESOURCE CENTER  
SANTEE SCHOOL DISTRICT**

operating and failure modes and compliance with Contract Documents, manufacturer's recommendations and the District's Project Requirements.

3. Ensure completion and coordination of the Work prior to testing. Preplan testing procedures, and ensure necessary staff and resources are on hand for expediting testing. Failure to complete or coordinate work, preplan, or have staff and resources available to carry out testing will result in retesting.
4. CxA will establish sampling protocol and, at the time of testing, select sample test locations for identical pieces of equipment. Receive CxA approval where simulation of conditions or altering of set points or values is required to achieve an opening or failure mode for testing.
5. Correct minor deficiencies during testing. Deficiencies that cannot be corrected during testing will be documented and subject to retest. Retesting will continue until no deficiencies remain.
6. The cost of retesting is the responsibility of the Contractor and subject to deductive change order. Deficiencies and retesting are the responsibility of the Contractor and are not subject to time extensions or delay claims. Review preliminary construction checklists and preliminary test procedures and data forms.

**3.2 OPERATION AND MAINTENANCE DATA**

- A. Provide as specified in Section 01 78 23 "Operation and Maintenance Data."

**3.3 DEMONSTRATION AND TRAINING**

- A. Provide as specified in Section 01 79 00 "Demonstration and Training."

**3.4 COMMISSIONING REPORT**

- A. CxA will provide Contractor, Architect, and District a Commissioning Report for the Project upon Substantial Completion. This report will include contact information for key members of the commissioning team; description of commissioned systems, commissioning activities, sampling protocol and results. The report will also include the District's Project Requirements, Basis-of-Design, Construction Verification Checklist Tracking Report, and Functional Performance Test Tracking Report.

**END OF SECTION 01 91 13**

**APPENDIX A – CONSTRUCTION VERIFICATION LIST**

Choose from the following Construction verification checklists and provide additional items as needed to reflect the verification Requirements of assemblies, components, equipment and systems to be commissioned on this Project and used on the Construction Verification Tracking Report.

CV-22 05 14 – Backflow Preventers  
CV-22 05 14 – Trap Primer Values  
CV-22 07 00 – Plumbing Insulation  
CV-22 11 00 – Water Distribution  
CV-22 13 00 – Sanitary Sewage  
CV-22 14 00 – Storm Drainage  
CV-22 30 00 – Expansion Tanks  
CV-22 30 00 – In-line Centrifugal Pumps  
CV-22 30 00 – Water Heaters (Electric)  
CV-22 30 00 – Water Heaters (Gas)  
CV-22 42 00 – Plumbing Fixtures  
CV-22 60 00 – Air Compressors  
CV-23 05 14 – Variable Frequency Drives  
CV-23 05 15 – Air Separators  
CV-23 05 15 – Expansion Tanks  
CV-23 05 15 – Suction Diffusers  
CV-23 07 00 – HVAC Ductwork Insulation  
CV-23 07 00 – HVAC Piping Insulation  
CV-23 09 14 - Air Compressors  
CV-23 09 14 - Control Wiring and Devices  
CV-23 11 00 - Gas Piping  
CV-23 21 13 - Hydronic Piping  
CV-23 21 13 - Pumps  
CV-23 23 00 - Refrigerant Piping / VRF, VRV  
CV-23 25 00 - HVAC Water Treatment  
CV-23 31 00 - Ductwork and Casings  
CV-23 34 00 - Ceiling Exhaust Fans  
CV-23 34 00 - Centrifugal Fans  
CV-23 34 00 - Destratification Fans  
CV-23 34 00 - Vaneaxial Fans  
CV-23 36 00 - Air Terminal Units  
CV-23 37 13 - Diffusers, Grilles and Registers  
CV-23 41 00 - Filter Racks  
CV-23 52 00 - Cast Iron or Modular Cast Iron Boiler  
CV-23 52 00 - Fire Box, Fire Tube, Flexible Water Tube or Vertical Tubeless Boilers  
CV-23 54 00 - Gas Fired Furnaces  
CV-23 55 00 - Direct Fired MUA Units  
CV-23 55 00 - Gas Fired Unit Heaters  
CV-23 55 00 - Indirect Fired MUA Units  
CV-23 62 13 - Air Cooled Chillers  
CV-23 64 15 - Water Cooled Chillers  
CV-23 73 12 - Refrigerant Coils  
CV-23 82 00 - Fan Coil Units  
CV-23 82 00 - Reheat Coils  
CV-23 82 00 - Unit Heaters  
CV-23 82 00 - Unit Ventilators  
CV-26 05 13 - Medium Voltage Cables  
CV-26 05 26 - Grounding and Bonding  
CV-26 05 33 - Conduit, Raceway & Boxes for Electrical Systems  
CV-26 05 36 - Cable Trays  
CV-26 18 23 - Medium Voltage Surge Arrestor  
CV-26 22 00 - Low Voltage Transformer

**SYCAMORE CANYON SCHOOL  
LIBRARY RESOURCE CENTER  
SANTEE SCHOOL DISTRICT**

- CV-26 24 13 - Switchboard
- CV-26 24 16 - Panelboards
- CV-26 27 13 - Electrical Meter
- CV-26 27 28 - Non-Fusible Disconnect Switches
- CV-26 28 16 - Enclosed Switches and Circuit Breakers
- CV-26 29 00 - Magnetic Motor Starters
- CV-26 29 00 - Manual Motor Starters
- CV-26 29 00 - Motor Control Centers
- CV-26 36 00 - Automatic Transfer Switches
- CV-26 43 13 - Transient Voltage Suppression
- CV-26 51 13 - Interior Light Fixtures, Lamps & Ballasts
- CV-26 51 15 - Lighting Control Panels
- CV-26 56 29 - Site Lighting
- CV-27 00 00 - Communications Cabling
- CV-28 31 00 - Fire Alarm Control Panels
- CV-28 31 00 - Fire Alarm Wiring & Devices

APPENDIX B – CONSTRUCTION VERIFICATION TRACKING REPORT

Fill out the following tracking report using Construction Verification List for this Project.

Construction Verification Checklist No.	Equipment/System Type	No. of Equip., Areas (floors, etc.) or Groups	Checklists Tracking	
			Total Checklists	Complete to Date

**SYCAMORE CANYON SCHOOL  
LIBRARY RESOURCE CENTER  
SANTEE SCHOOL DISTRICT  
APPENDIX C – FUNCTIONAL PERFORMANCE TEST LIST**


Choose from the following Functional Performance Test list and provide additional items needed to reflect the Testing Requirements of assemblies, components, equipment and systems to be commissioned on this Project and used on Functional Performance Test Tracking Report.

- FPT-22 30 00 - Domestic Booster Pumps
- FPT-22 30 00 - Inline Centrifugal Pumps
- FPT-22 30 00 - Water Heaters
- FPT-23 05 14 - Variable Frequency Drives
- FPT-23 09 23 - EMS Communication/Calibration
- FPT-23 21 13 - Pumps
- FPT-23 34 00 - HVAC Fans
- FPT-23 36 00 - Air Terminal Units
- FPT-23 52 00 - Boiler
- FPT-23 54 00 - Gas Fired Furnaces
- FPT-23 55 00 - Direct Fired MUA Units
- FPT-23 55 00 - Gas Fired Unit Heaters
- FPT-23 62 13 - Air-Cooled Chillers
- FPT-23 64 15 - Water Cooled Chillers
- FPT-23 73 13 - Air Handling Units/VRF, VRV
- FPT-23 82 00 - Cabinet Heaters
- FPT-23 82 00 - Fan Coil Units
- FPT-23 82 00 - Re-Heat Coils
- FPT-23 82 00 - Unit Heaters
- FPT-26 51 15 - Lighting Controls

**APPENDIX D – FUNCTIONAL PERFORMANCE TEST TRACKING REPORT**

Fill out the following tracking report using the Functional Performance Test List for this Project.

Functional Performance Test No.	Equipment/System Type	No. of Equip., Areas (floors, etc.) or Groups	Test Tracking	
			Total Tests	Complete to Date

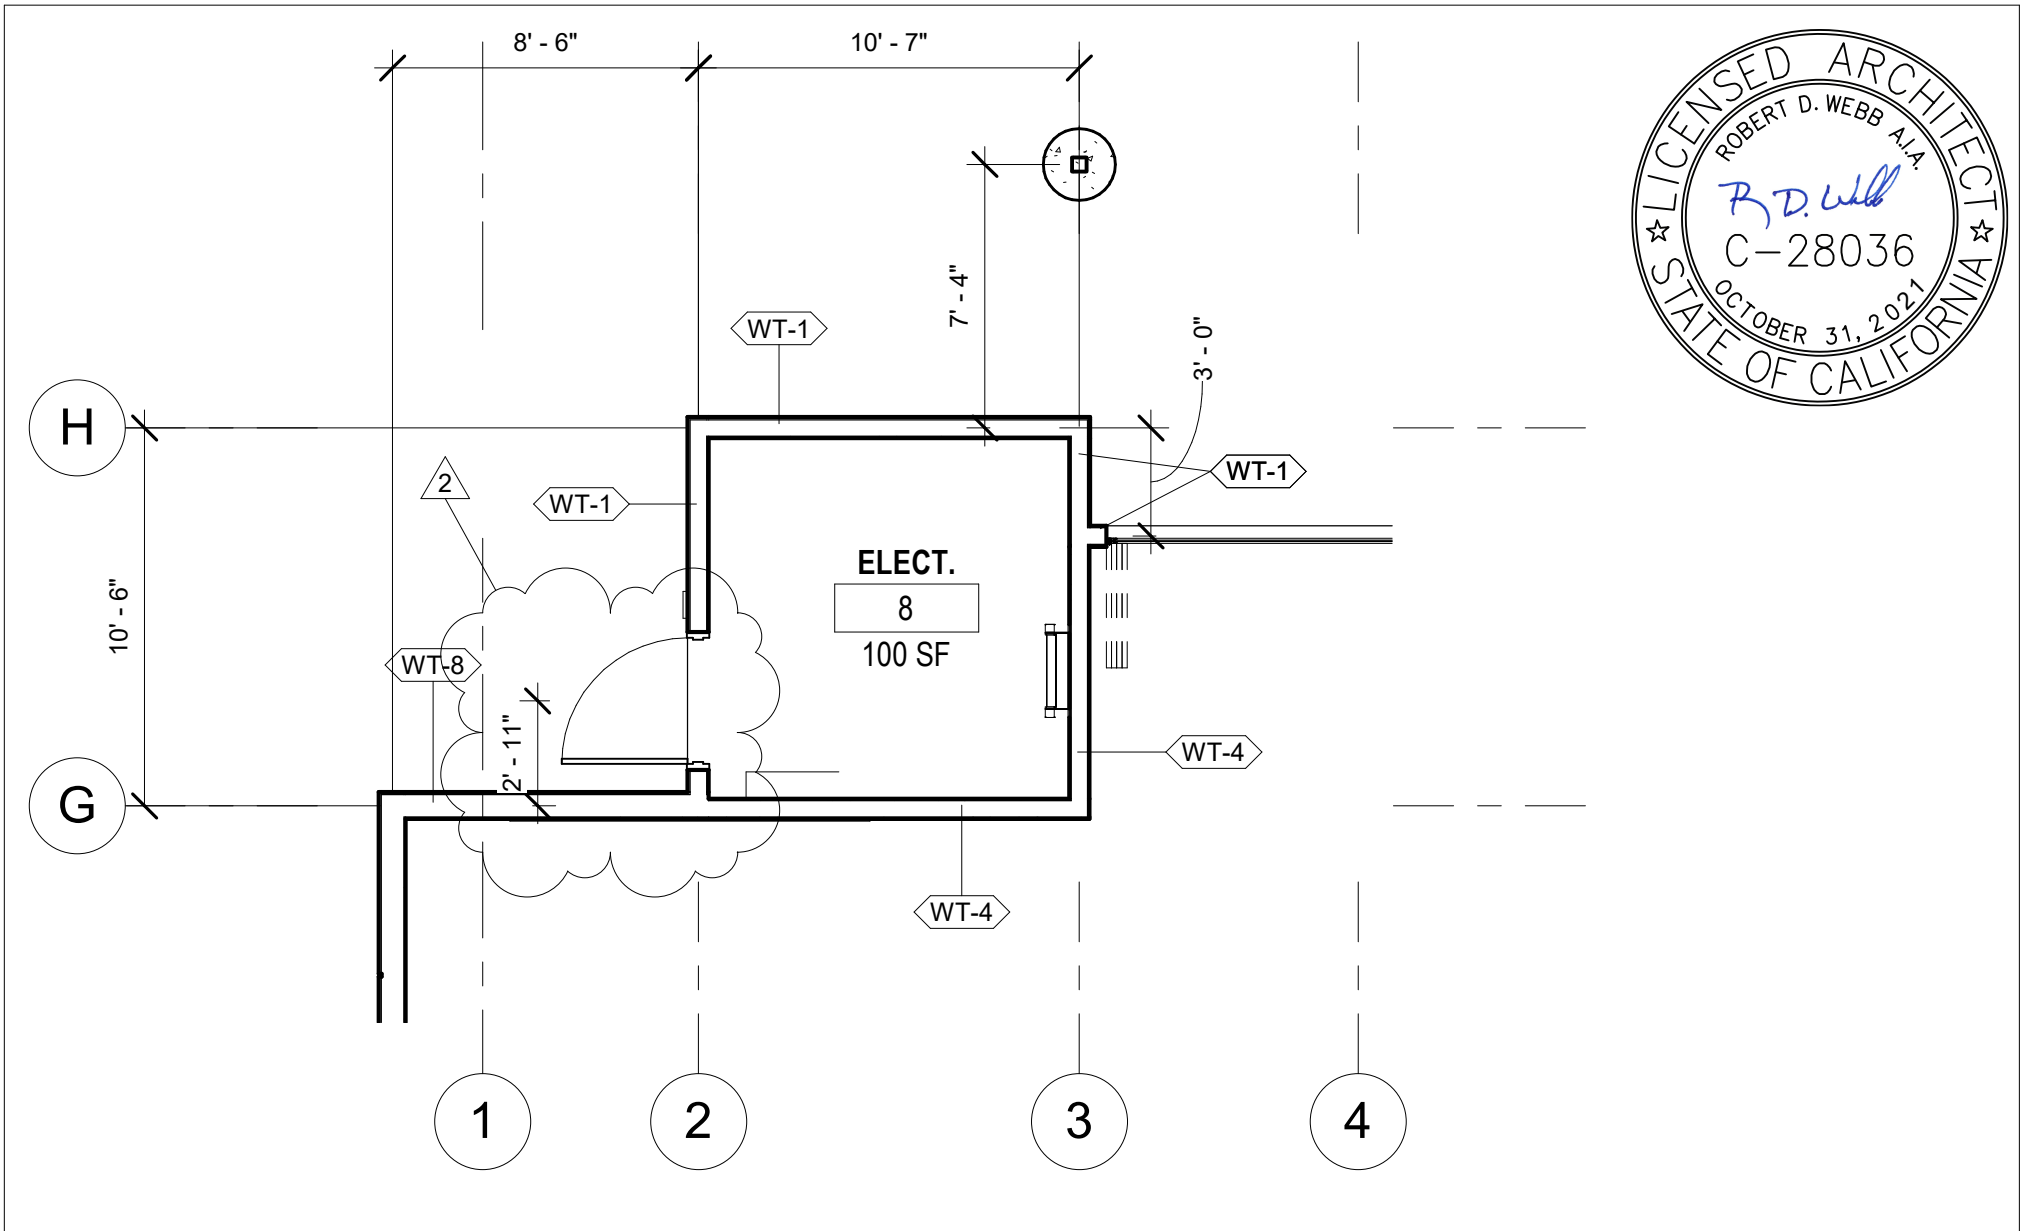

**PARTIAL ENLARGED FLOOR PLAN- DIMENSION**

3/16" = 1'-0"

**1**

SHEET NO.

**AD2-A2.1**

DSA APPL. NO.  
04-118743

DATE:  
03/16/20

SYCAMORE CANYON ELEM. SCHOOL  
LIBRARY RESOURCE CENTER (LRC)



SANTEE SCHOOL DISTRICT




515 Encinitas Blvd. Ste. 201, Encinitas, California 92024  
Telephone: (760)753-6800 Fax: (760)452-7541

**KEY NOTES:**

- ① PROVIDE WALL MOUNTED J-BOX THEN ROUTE CONDUIT DOWN EXTERIOR WALL TO UNDERGROUND.
- ② ROUTE IN SOFFIT.
- ③ ROUTE CONDUIT ABOVE CEILING THROUGH BUILDING (TYPICAL).
- ④ PROVIDE FIBER OPTIC FEED CABLE (DATA) AND OTHER LOW VOLTAGE FEED CABLES AS SHOWN IN THE RISER DIAGRAM AND SPECIFICATIONS FROM THE NEW IDF CLOSET IN BLDG. 'H' TO THE EXISTING MDF ROOM IN BLDG. 'C'.
- ⑤ SEE E3.1 FOR EQUIPMENT LOCATIONS
- ⑥ EXISTING 4'x6' UNDERGROUND PULLBOX.
- ⑦ EXISTING 2'x3' UNDERGROUND PULLBOX.
- ⑧ EXISTING 4" C. SPARE STUBBED INTO MDF ROOM.
- ⑨ STUB AND CAP BELOW GRADE FOR FUTURE.
- ⑩ ROUTE (2) 2" C. COMM. TO NEW PULLBOX.

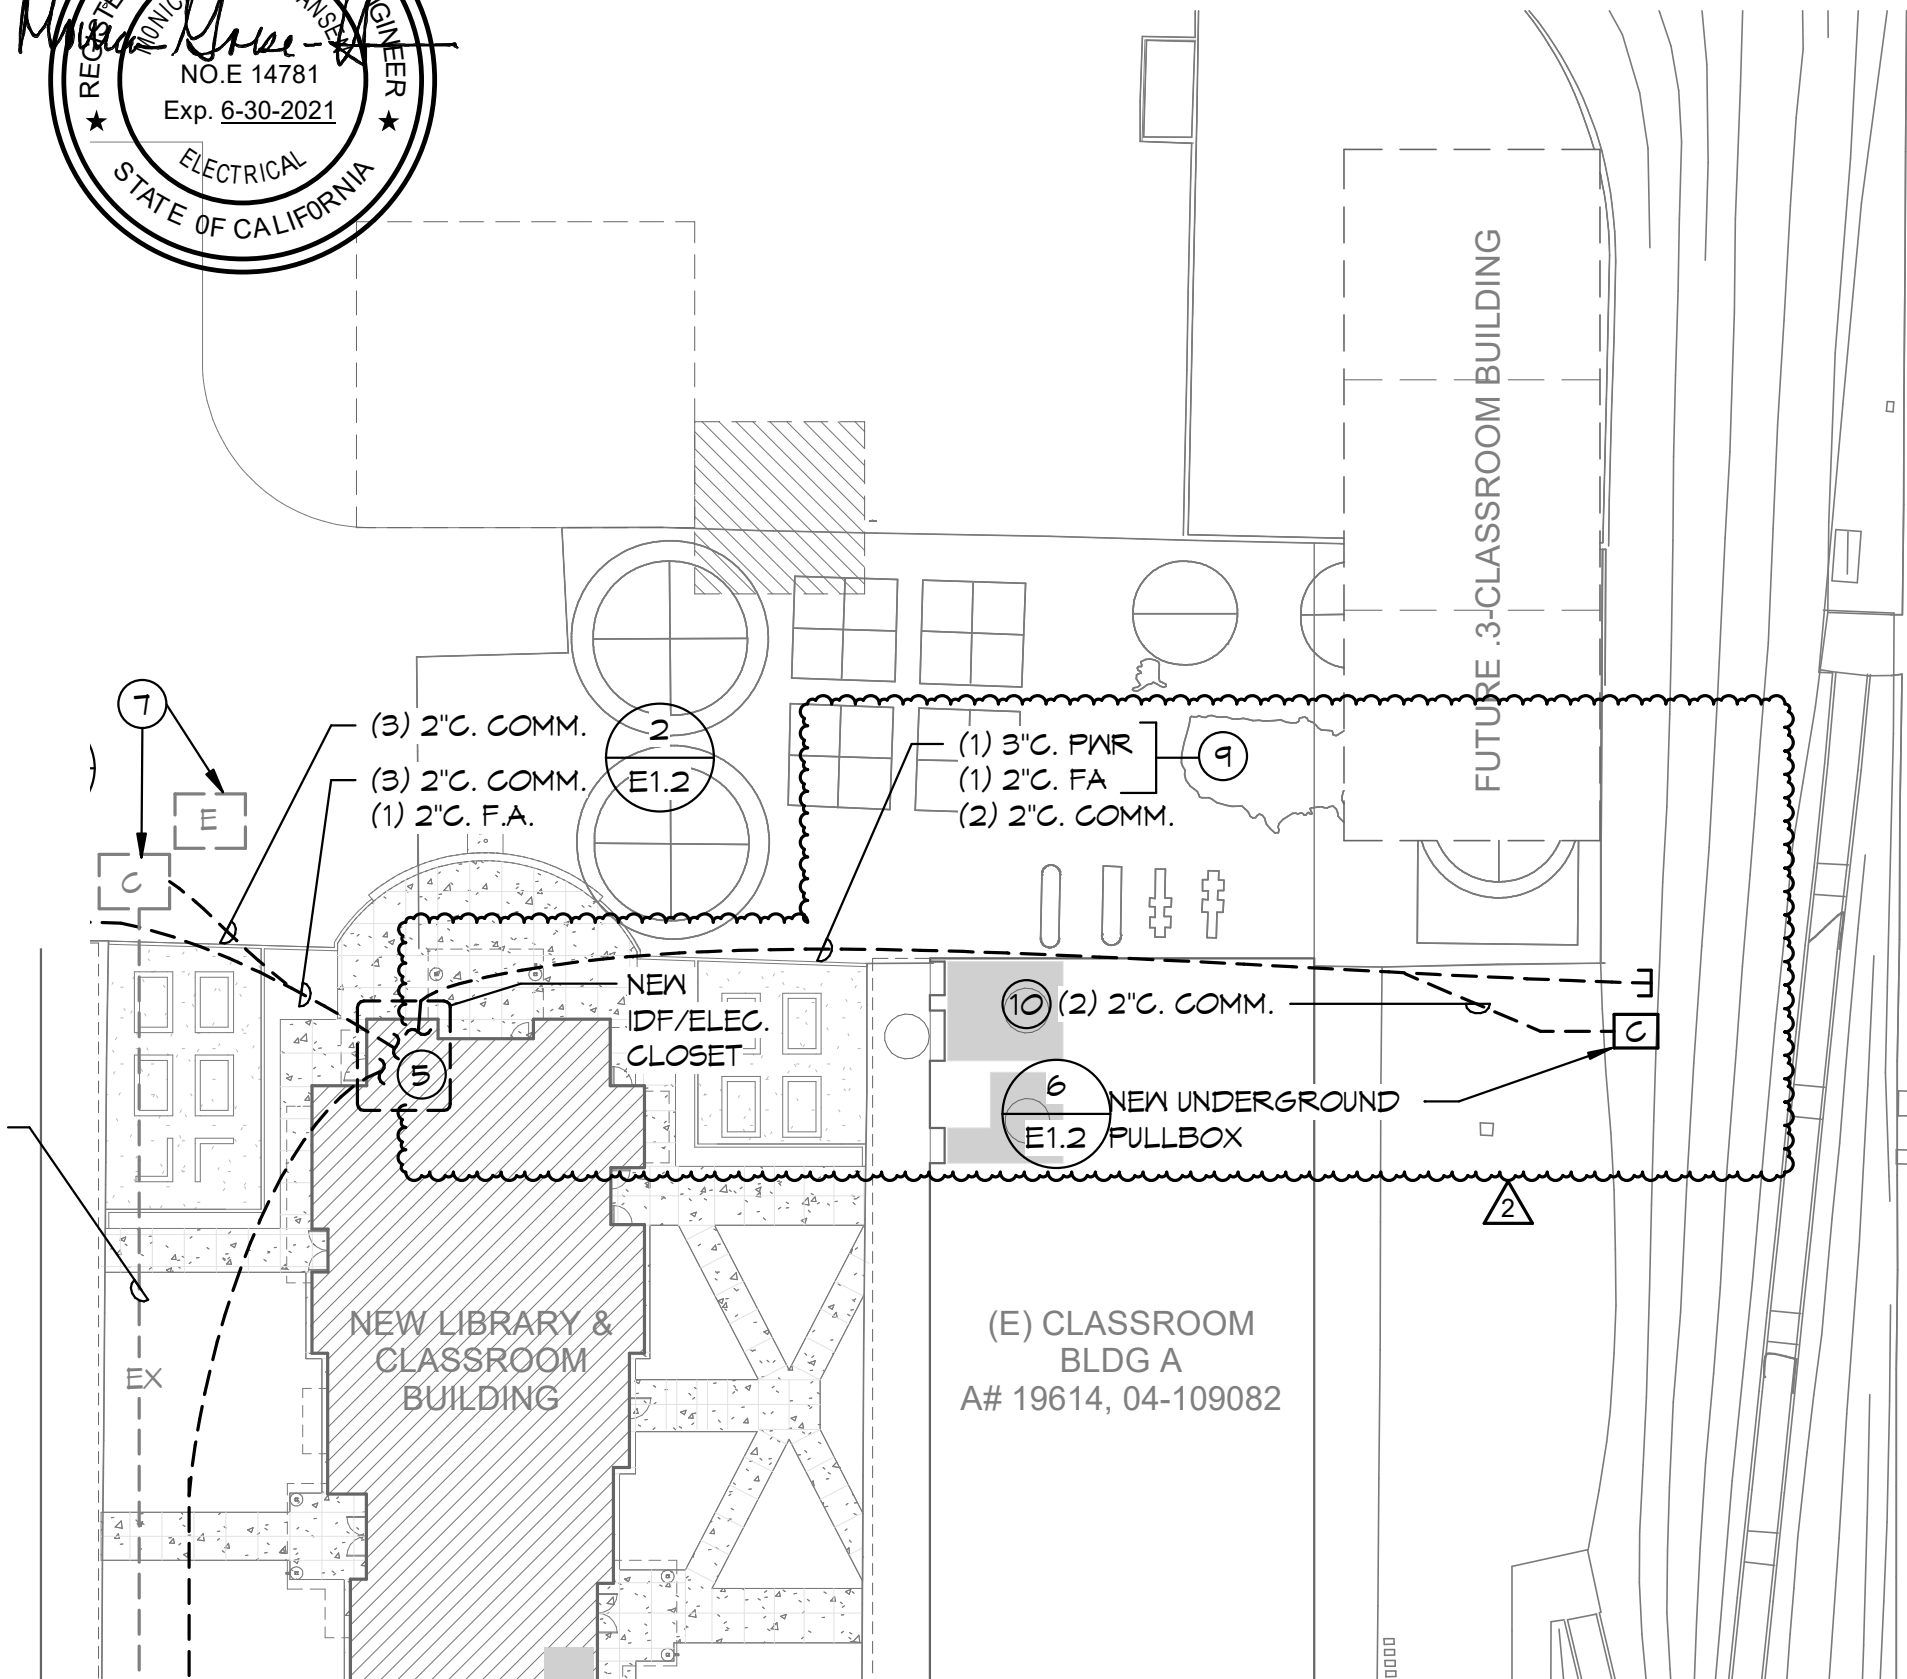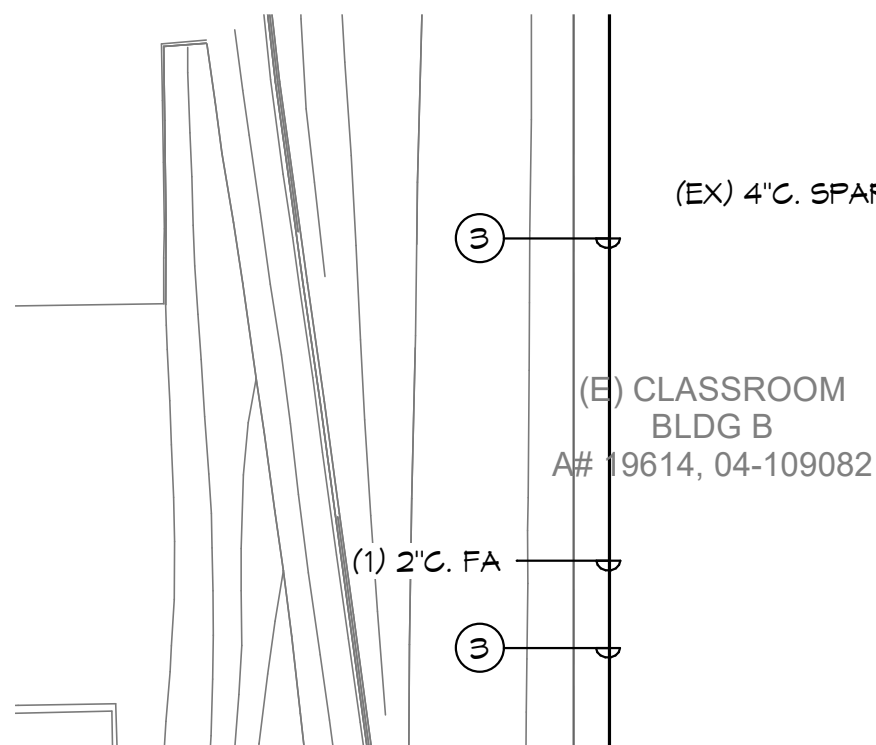



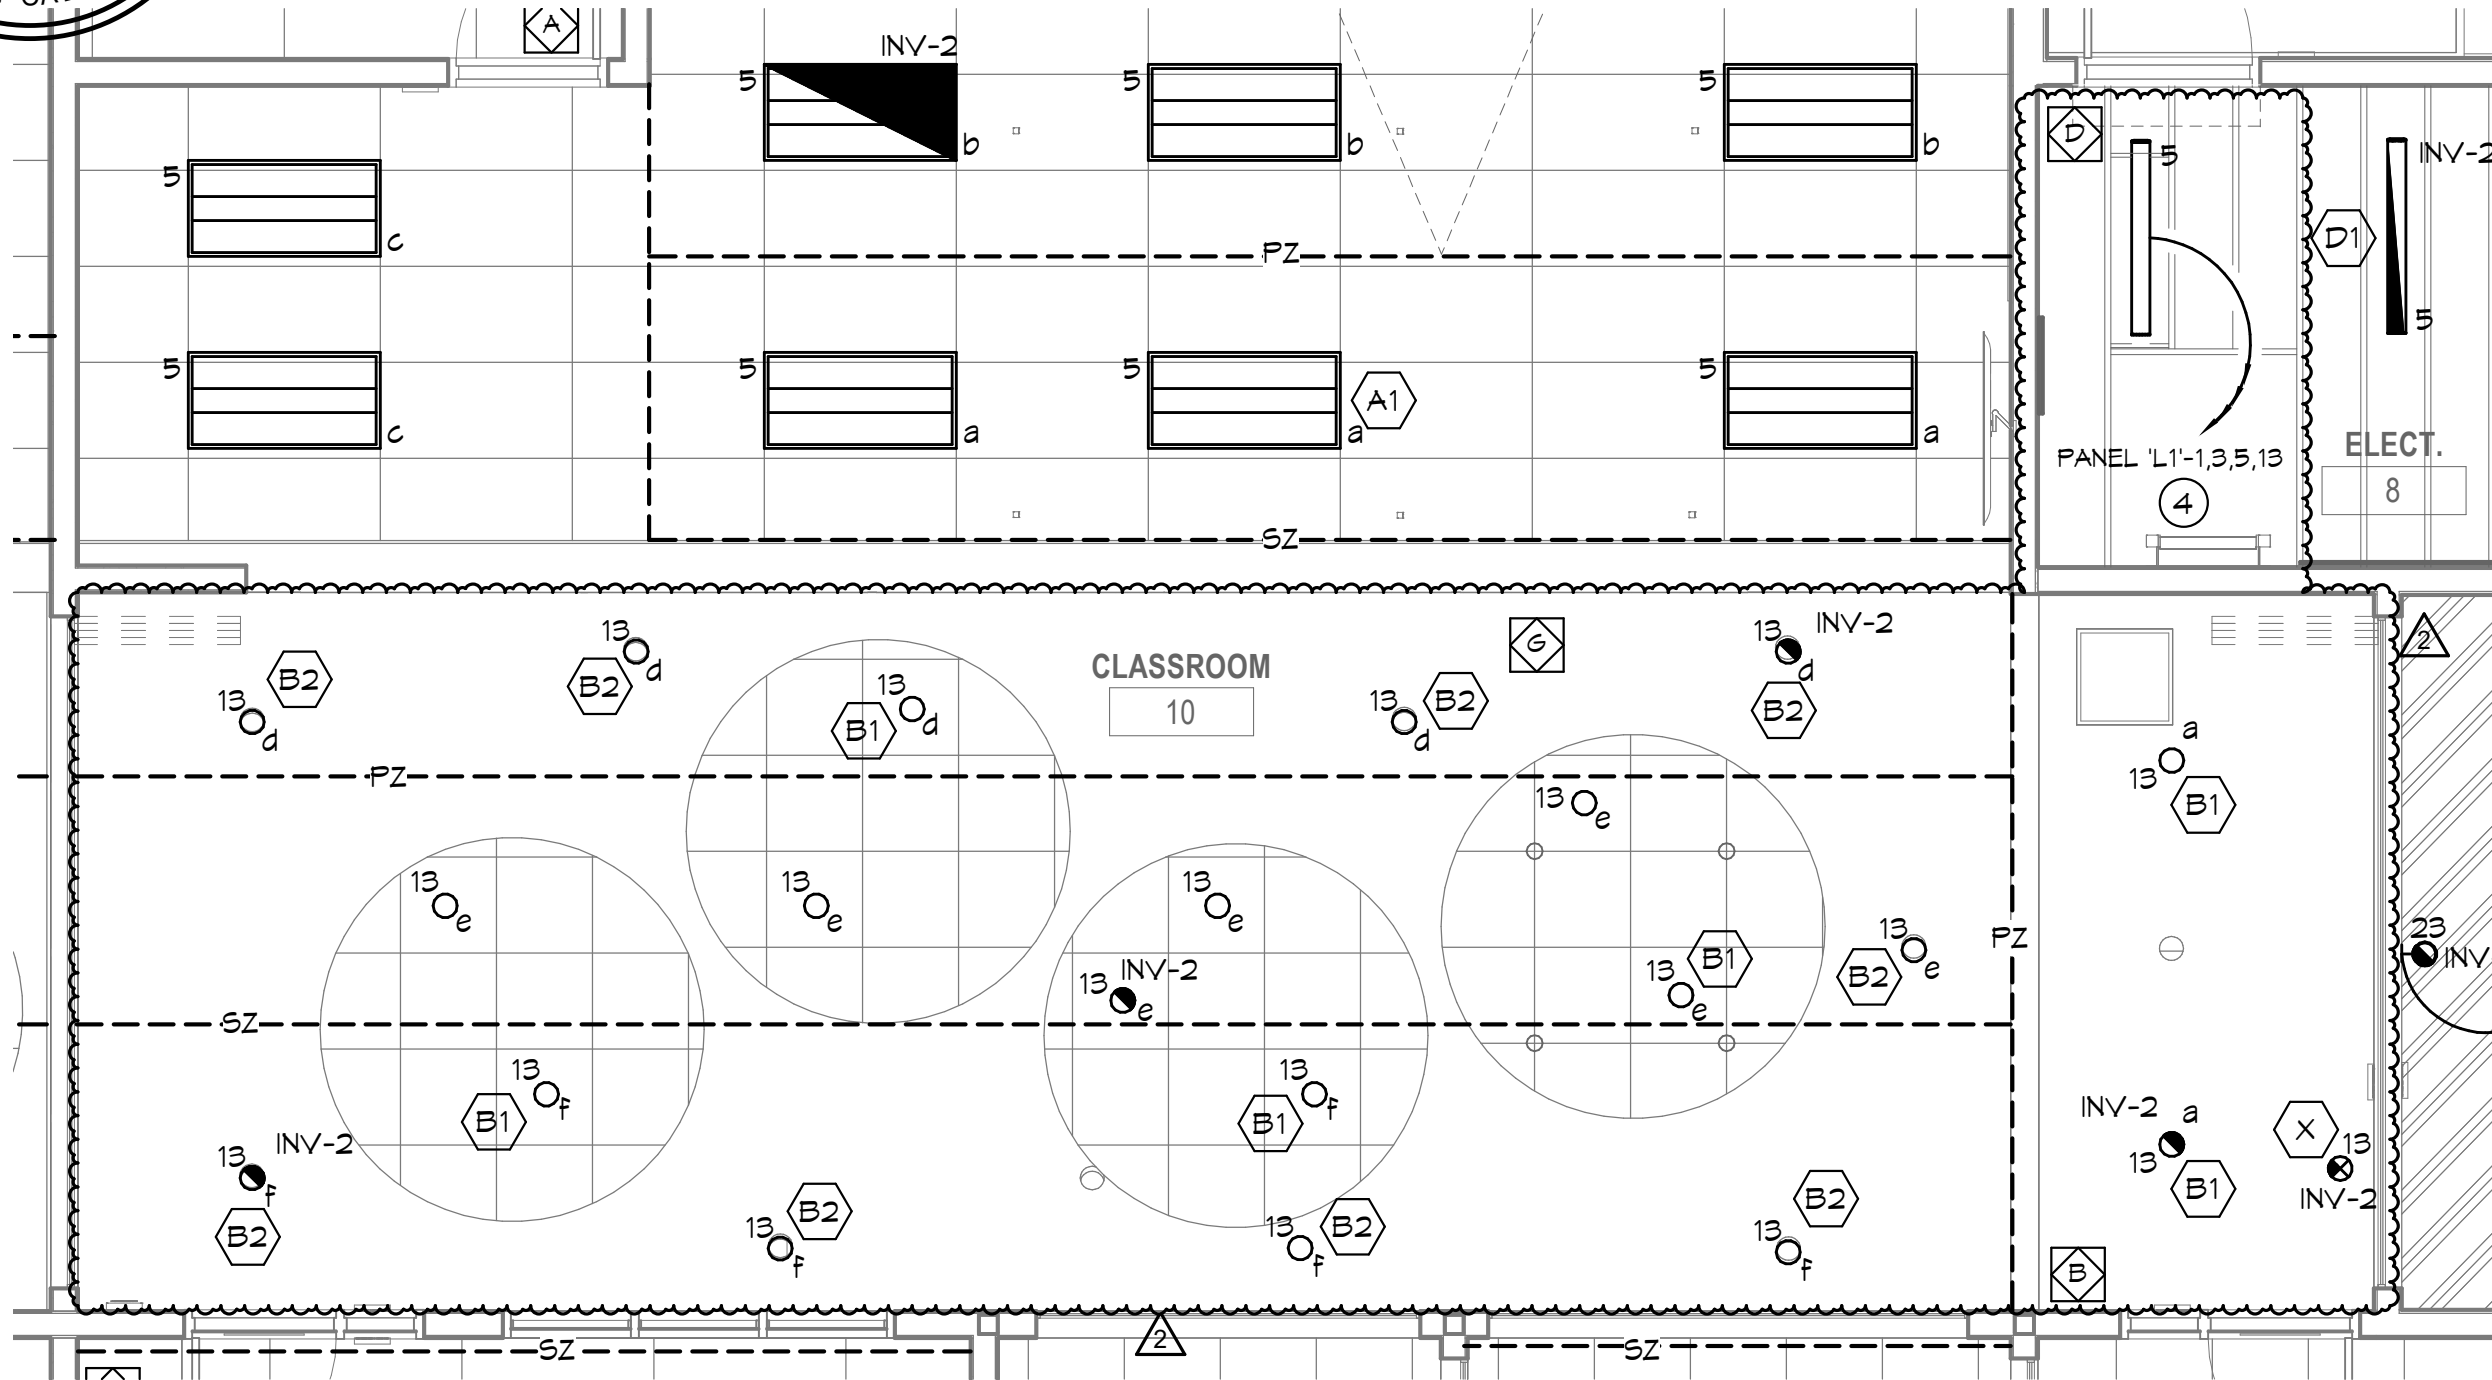

LEVEL 1 FLOOR PLAN - LIGHTING

1/4" = 1'-0"

1



SHEET NO.  
AD2-E2.1

04-118473

SYCAMORE CANYON ELEM. SCHOOL  
LIBRARY RESOURCE CENTER (LRC)  
SANTEE SCHOOL DISTRICT

**studiowc**  
ARCHITECTURE + ENGINEERING

515 Encinitas Blvd. Ste. 201, Encinitas, California 92024  
Telephone: (760)753-6800 Fax: (760)452-7541

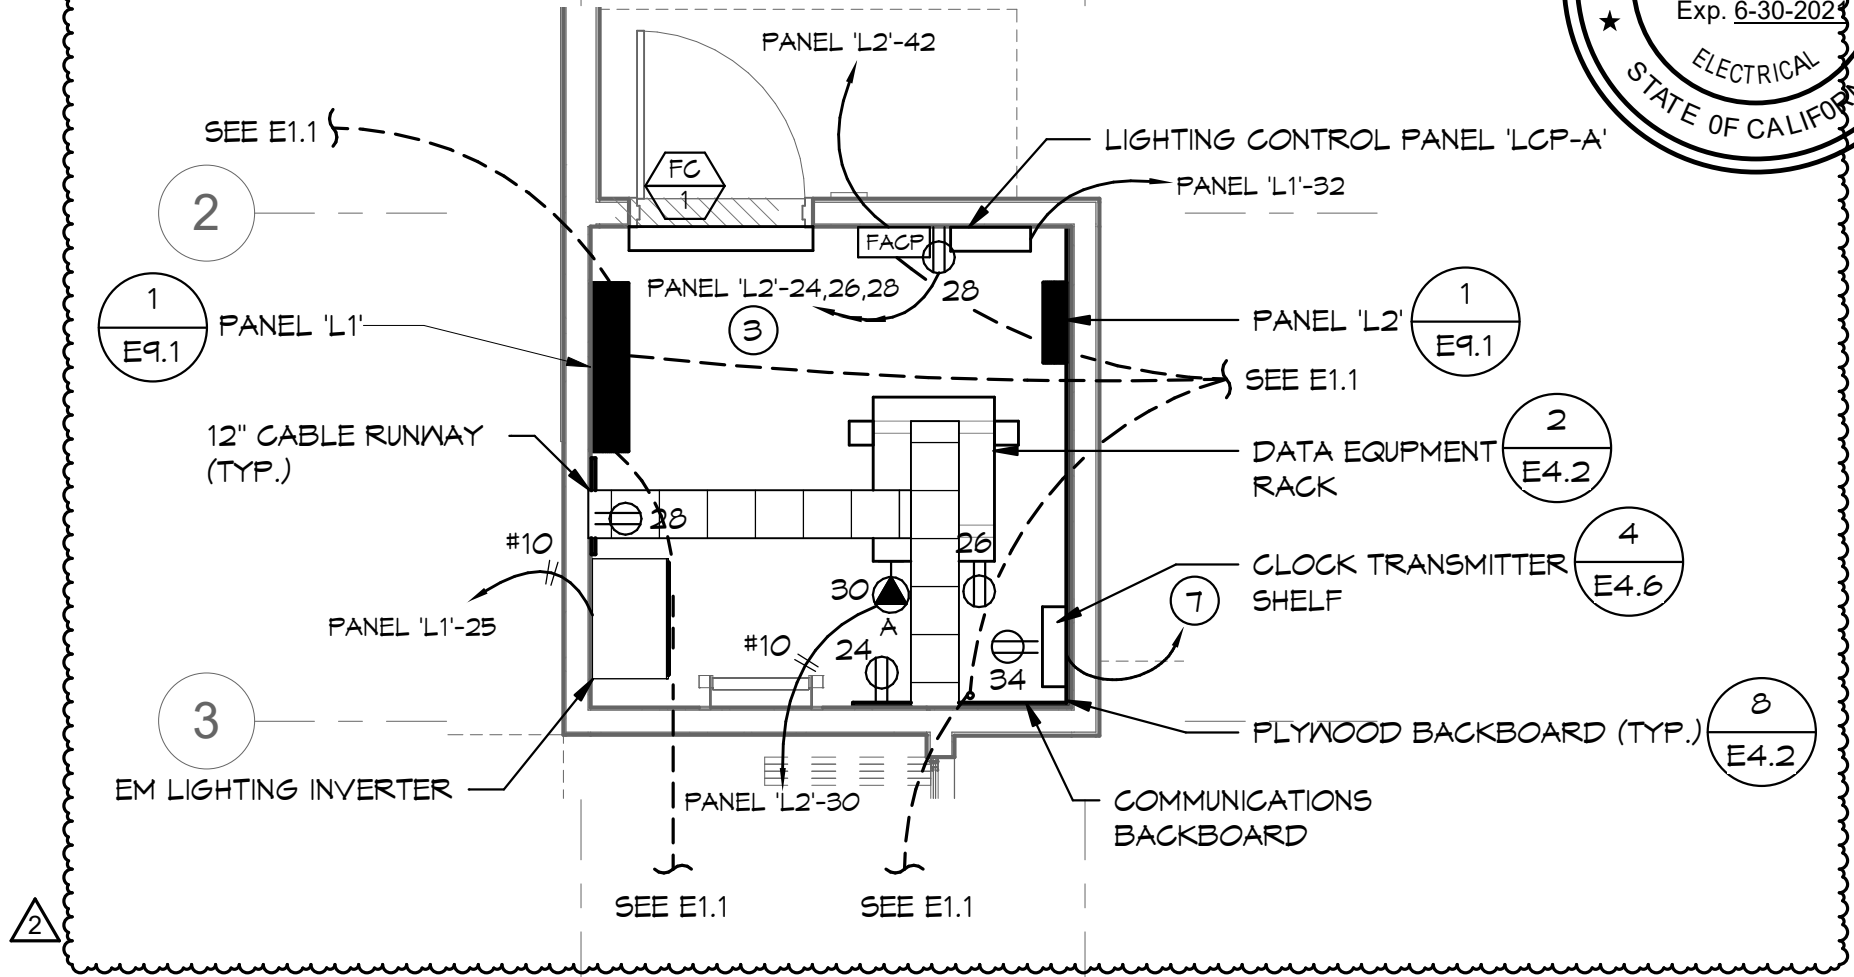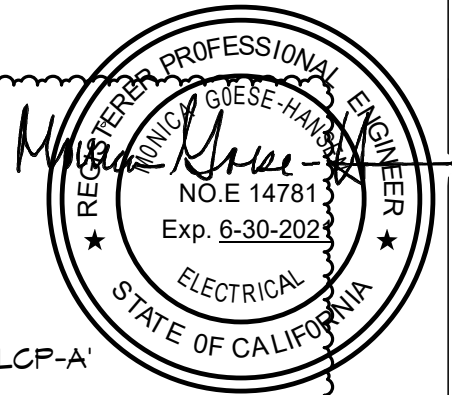

# LEVEL 1 - ENLARGED ROOM PLAN

1/4" = 1'-0"

2

SHEET NO.

AD2-E3.1

DSA APPL. NO.

04-118743

DATE:

3-16-20

SYCAMORE CANYON ELEM. SCHOOL

LIBRARY RESOURCE CENTER (LRC)

SANTEE SCHOOL DISTRICT




515 Encinitas Blvd. Ste. 201, Encinitas, California 92024  
 Telephone: (760)753-6800 Fax: (760)452-7541



**KEY NOTES:**

① EXISTING REMOTE ANNUNCIATOR TO BE DISCONNECTED AND REMOVED. PROVIDE NEW REMOTE ANNUNCIATOR AT EXISTING LOCATION. PROVIDE ALL REQUIRED WIRING, CARDS, SOFTWARE AND PROGRAMMING FOR A COMPLETE SYSTEM.

②

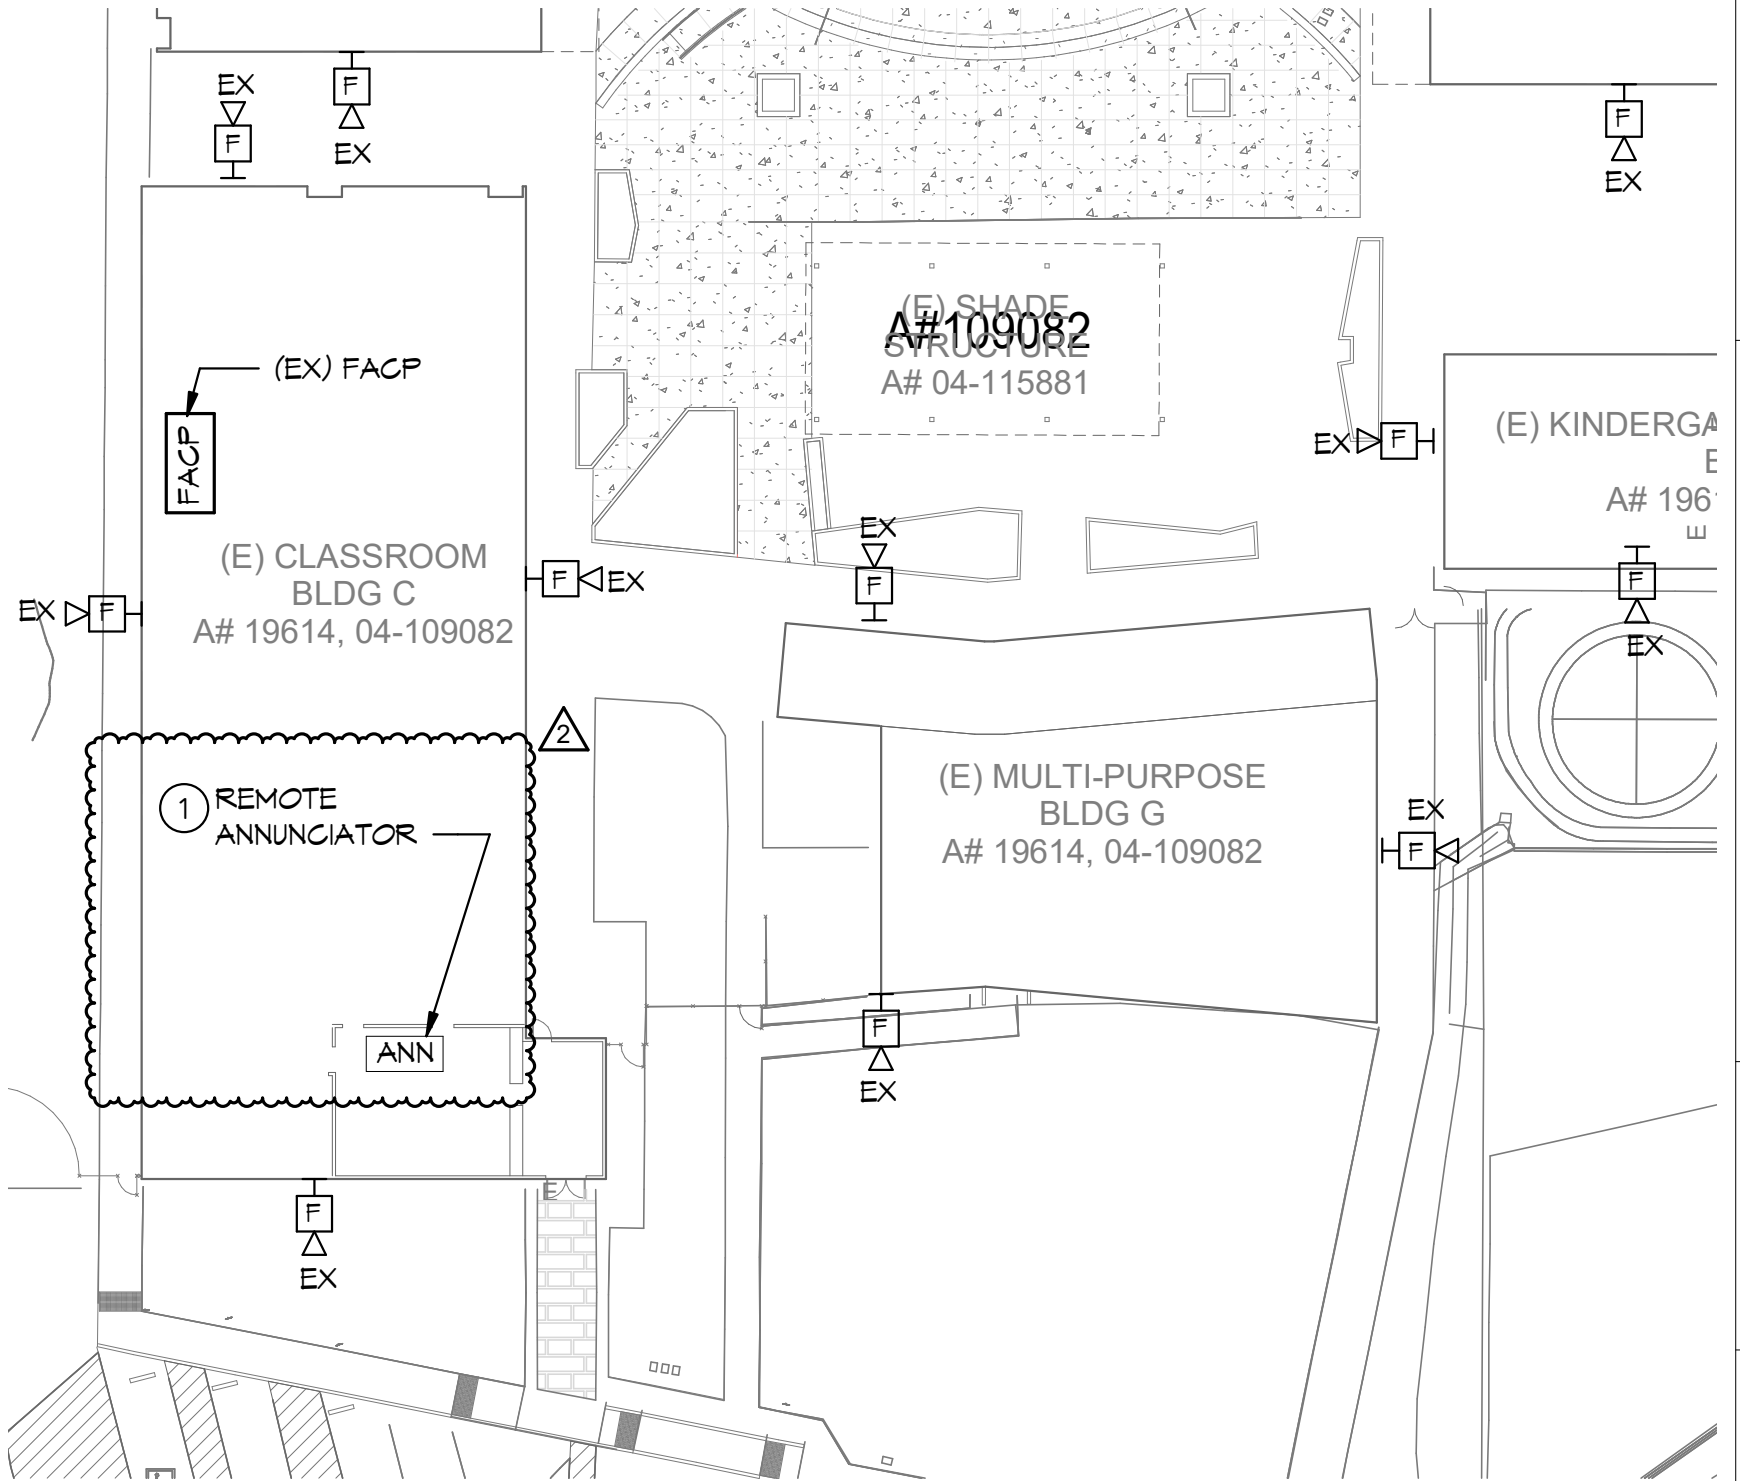



FCI MODEL E3					
	SYM	MODEL NO.	DESCRIPTION	C.S.F.M. LISTING	MFG.
	FACP	FCI-E3	FIRE ALARM CONTROL PANEL/VOICE EVAC	7165-1703:0125	GAMEWELL FCI
2	SM	SERIES DMS	SYNG MODULE	7300-0785:0132	COOPER WHELOCK
	ANN	GFANN-80	REMOTE ANNUNCIATOR	7120-1703:0183	GAMEWELL FCI
	S <sub>C</sub>	MCS-COF	INTELLIGENT SMOKE /CO DETECTOR	7275-1703:0175	GAMEWELL FCI
		B200S	SENSOR SOUNDER BASE	7300-1653:0213	SYSTEM SENSOR
	S	ASD-PL2F	INTELLIGENT SMOKE DETECTOR	7272-1703:0121	GAMEWELL FCI
		B210LP	SENSOR BASE	7300-1653:0109	SYSTEM SENSOR
				7300-1653:0109	SYSTEM SENSOR
	H <sub>A</sub>	ATD-HL2F	INTELLIGENT HEAT DETECTOR (ABOVE CEILING)	7270-1703:0115	GAMEWELL FCI
		B501	SENSOR BASE	7300-1653:0109	SYSTEM SENSOR *
	H <sub>F</sub>	ET1010	EXTERIOR SPEAKER W/WBB BACKBOX	7320-0785:0105	COOPER WHELOCK
	□	LSTC	STROBE (15/30/75/110) cd (CEIL MNT)	7125-0785:0180	COOPER WHELOCK
	○	LSPSTC	SPEAKER/STROBE - CEILING	7125-0785:0178	COOPER WHELOCK
	H <sub>○</sub>	LSPST	SPEAKER/STROBE - WALL	7125-0785:0175	COOPER WHELOCK
	M	AMM-2F	ADDRESSABLE MONITOR MODULE	7300-1703:0102	GAMEWELL FCI
	R	AOM-2RF	ADDRESSABLE RELAY MODULE	7300-1703:0102	GAMEWELL FCI
	R1	RIC-1	120 VOLT RELAY MODULE	7300-1004:0101	SAE INC
	~	TYPE FPL	SIGNAL LINE CIRCUIT CONDUCTORS ('M')	7161-0859:0101	WEST PENN
	~	TYPE THHN	AUDIO VISUAL AND POWER CONDUCTORS (AV,P)	N/A	SOUTHWIRE


\* IF OTHER MANUFACTURER IS USED IT IS TO BE UL. AND CSFM LISTED.

### ANNUNCIATOR ZONE SCHEDULE

	ROOM SMOKE/CO OR HEAT DETECTORS	ABOVE CEILING HEAT DETECTORS	SPRINKLER SYSTEM	TROUBLE INDICATION
BLDG. SCE	YES	YES	N/A	YES

**NOTES:**

- ALL SMOKE DETECTORS/CO DETECTORS, HEAT DETECTORS ABOVE CEILING DETECTORS, DUCT DETECTORS MANUAL PULL STATIONS, FLOW SWITCHES, TAMPER SWITCHES SHALL BE INDIVIDUALLY ADDRESSABLE.
- 2 PROVIDE (1) ANNUNCIATOR AT BLDG. 'C' WHICH WILL PROVIDE LED LIGHT INDICATORS TO IDENTIFY THE ABOVE ZONE SCHEDULE (IN ADDITION TO ANNUNCIATOR NOTED IN NOTE # 3).
- 3 PROVIDE (1) 32 CHARACTER BACK-LIGHTED ALPHA-NUMERIC DISPLAY ANNUNCIATOR WITH KEYPAD FOR OPERATOR CONTROL, PROGRAMMING AND TESTING.

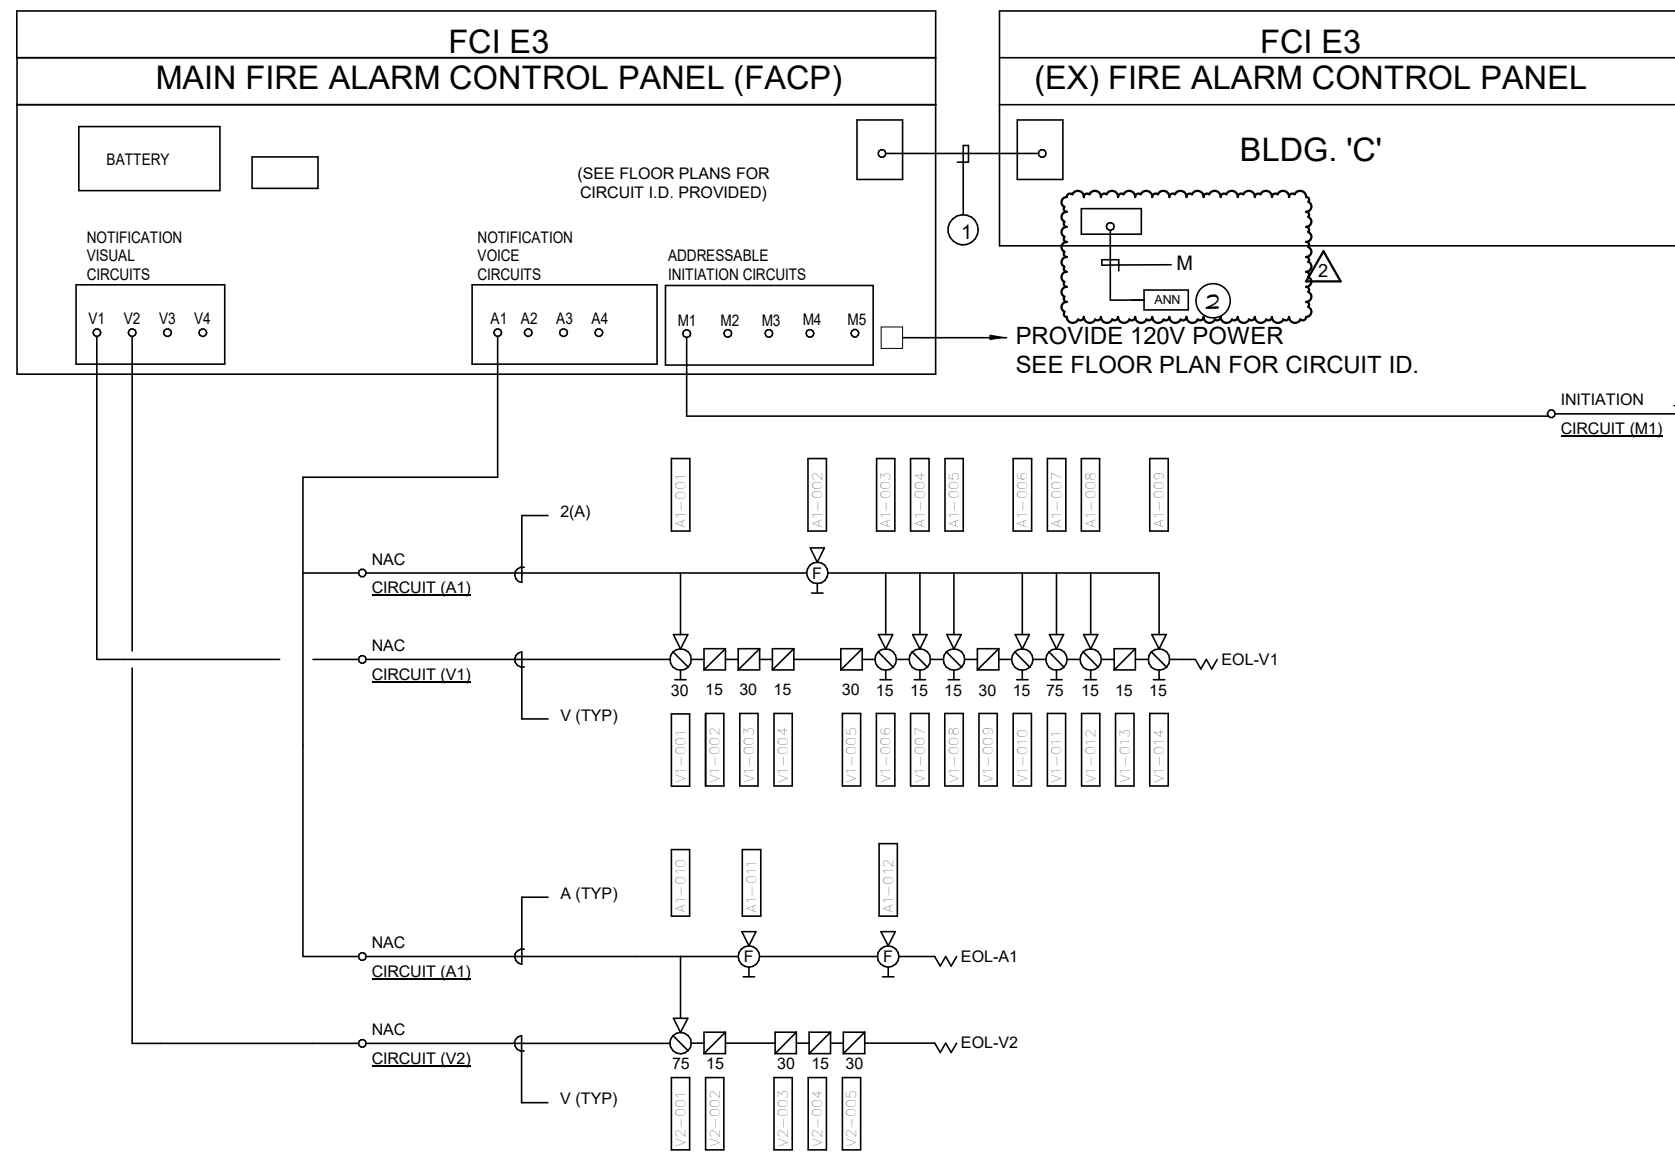



**GENERAL NOTES:**

1. ALL WIRING INDICATED IS FOR GENERAL REFERENCE ONLY. CONTRACTOR SHALL PROVIDE ALL WIRING AND COMPONENTS NEEDED TO PROVIDE A COMPLETE OPERATIONAL SYSTEM.
2. REFERENCE FLOOR PLANS FOR EXACT QUANTITY, TYPE, AND LOCATION OF ALL DEVICES.
3. PROVIDE ALL SOFTWARE AND PROGRAMMING FOR A COMPLETE SYSTEM.

**KEYNOTES**

- ① FIRE ALARM FIBER NETWORK
- ② PROVIDE NEW REMOTE ANNUNCIATOR AT EXISTING LOCATION. PROVIDE ALL REQUIRED WIRING, CARDS, SOFTWARE AND PROGRAMMING FOR A COMPLETE SYSTEM.

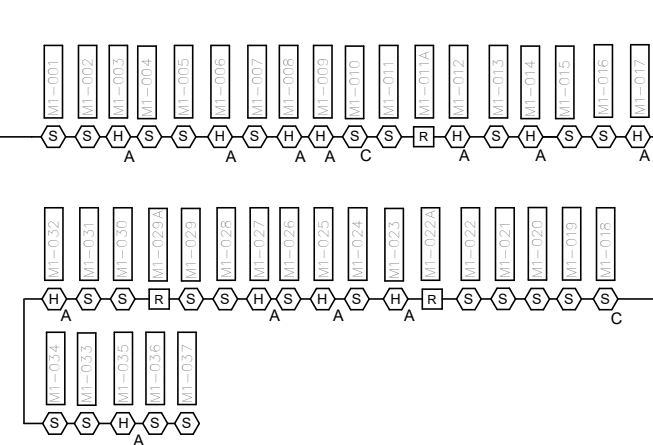

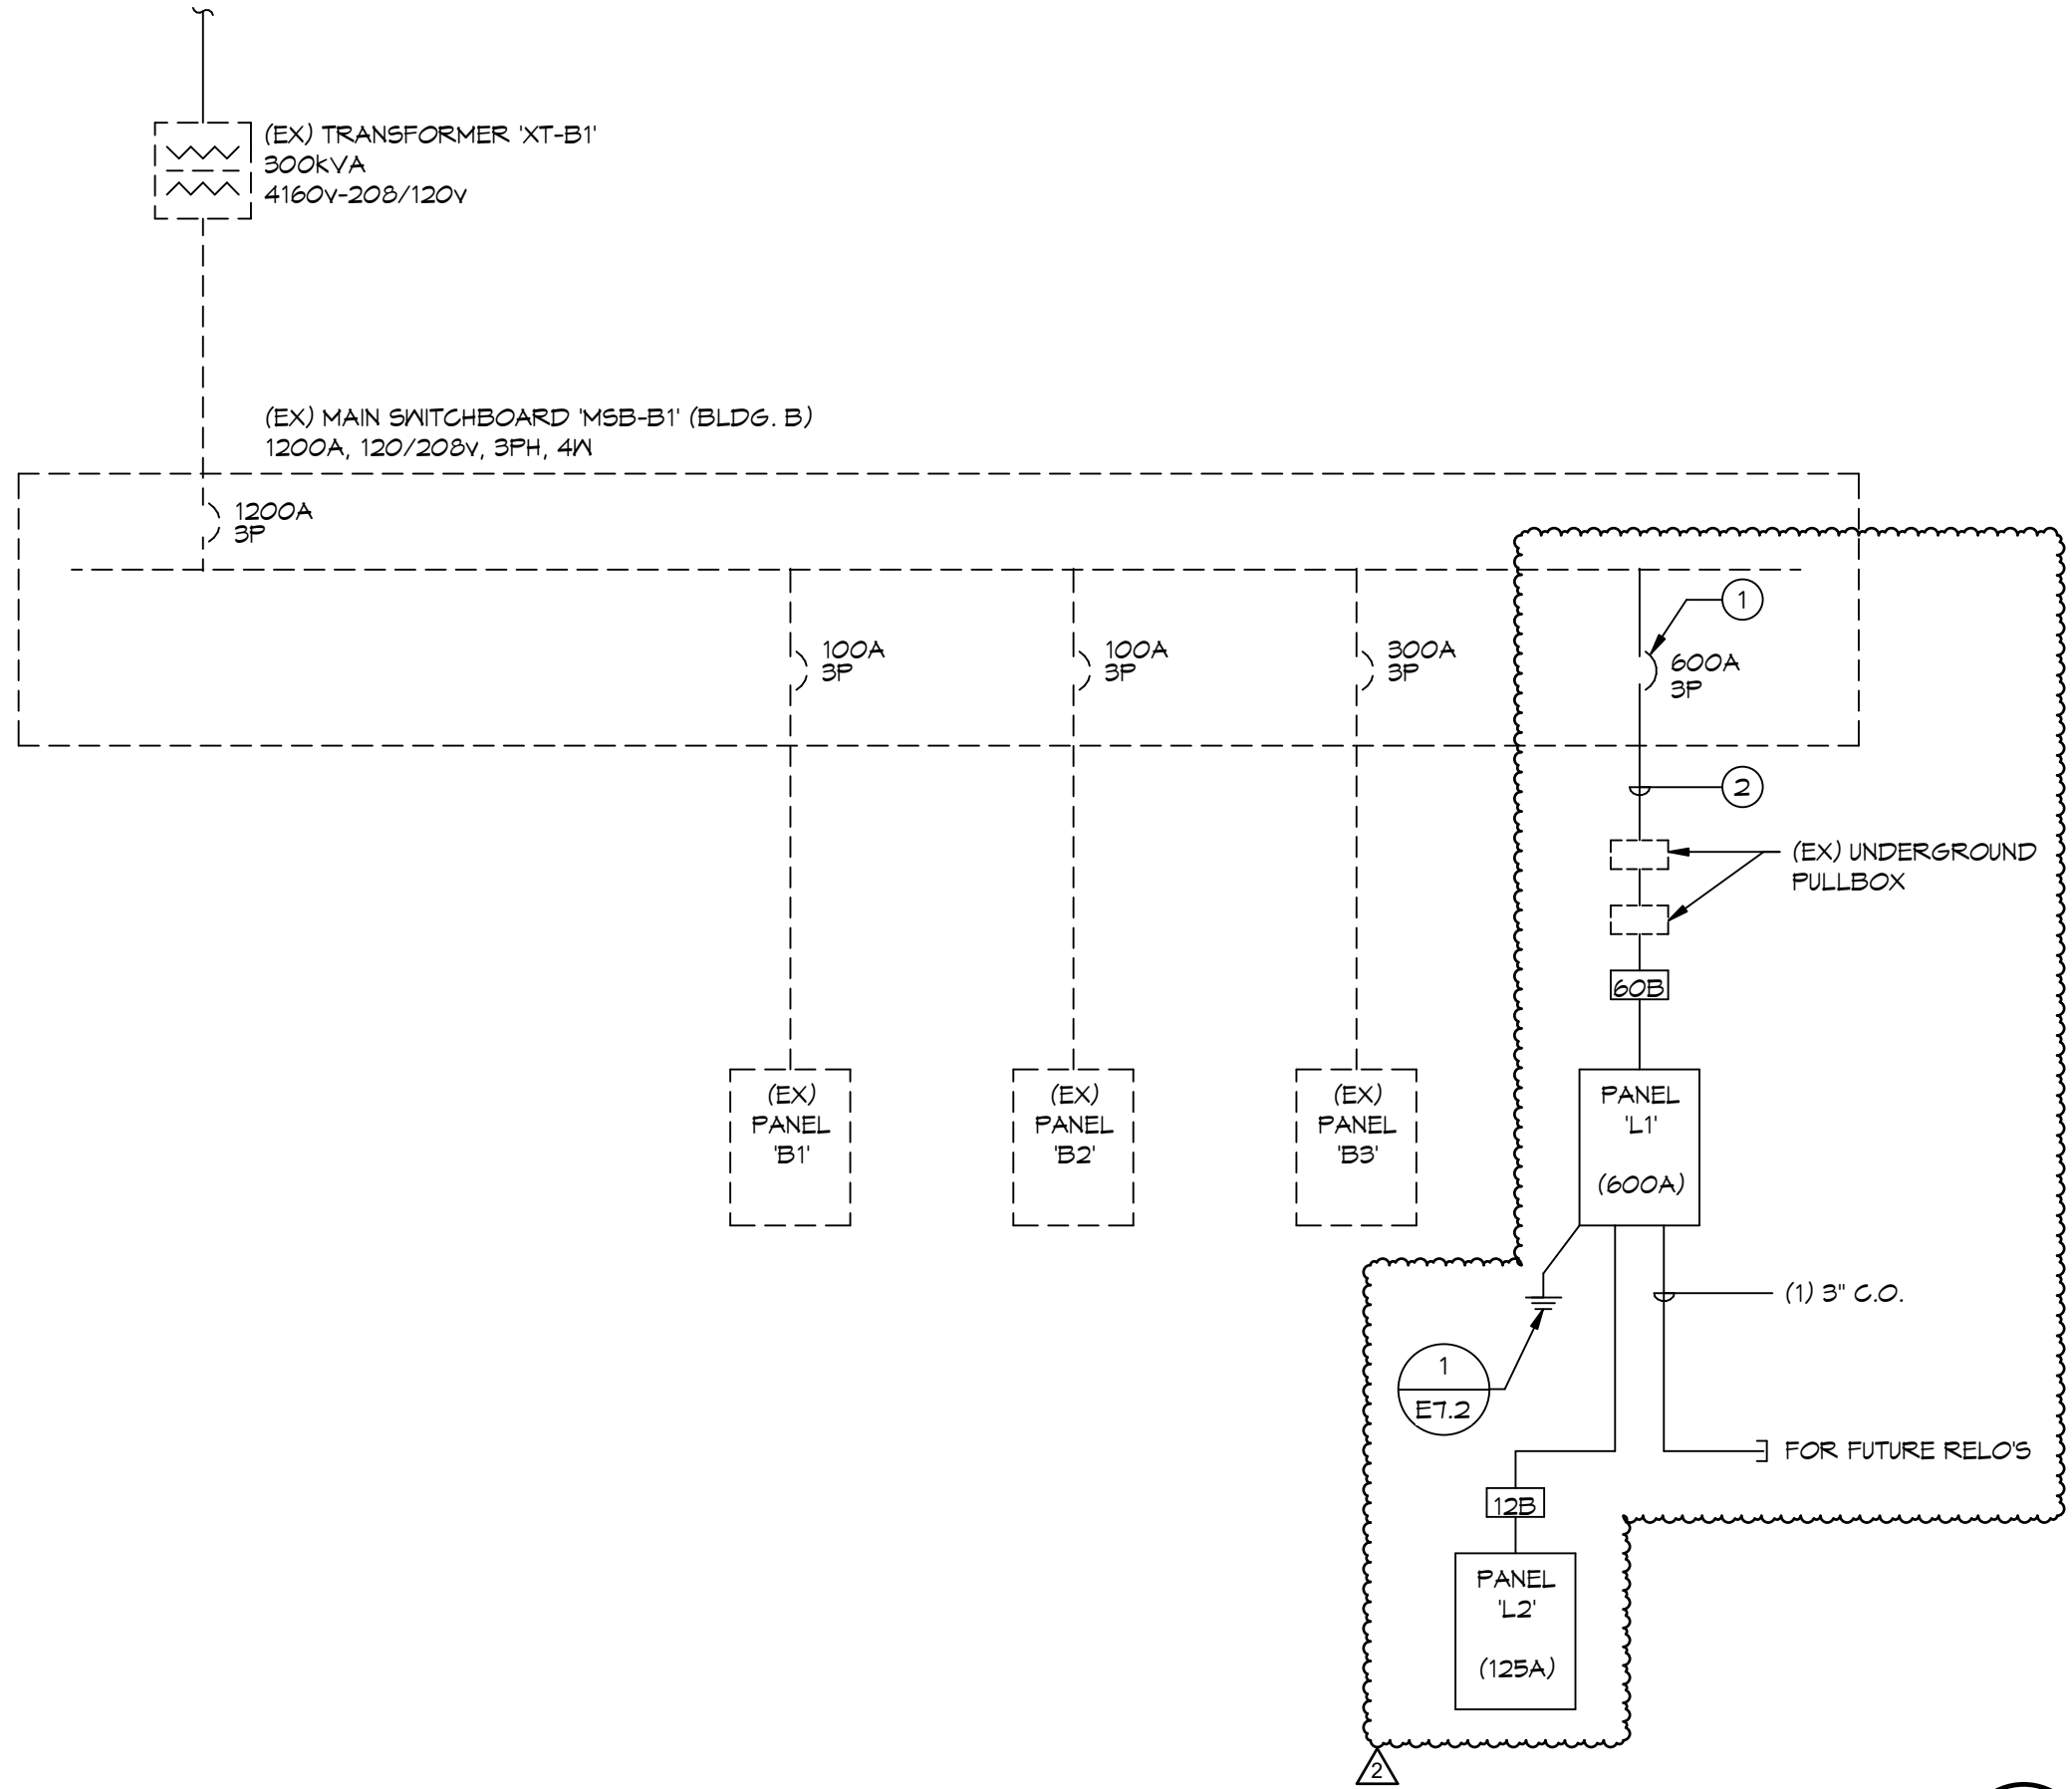

**ONE-LINE DIAGRAM**  
NO SCALE

1  
E7.1



2

120/208		120/208 3PH, 4WIRE		600 AMP			Main	Breaker	ENCLOSURE TYPE		ENCLOSURE NOTE				
		200% Neutral Bus						X	X	NEMA TYPE 1					
		(INTEGRAL)TVSS Protection								NEMA TYPE 3R					
		(REMOTE)TVSS Protection					Enclosure	Surface	X	NEMA TYPE 4X					
L1		Service Entrance Rated		GENERAL DISTRIBUTION			PROVIDE LOCK ON BREAKER DEVICES FOR ALL EMERGENCY LIGHTING,								
		Load Side Feed thru Lugs		BREAKER REQUIREMENTS :			MOTORS, AND FIRE ALARM EQUIPMENT SERVED FROM THIS PANEL								
LCL	NHL	CIRCUIT DESCRIPTION	AMP	POLE	NO	PHASE A	PHASE B	PHASE C	NO	AMP	POLE	CIRCUIT DESCRIPTION	LCL	NHL	
X		INTERIOR LTG	20	1	1	850			2	40	3	AC-1			
X		INTERIOR LTG	20	1	3	3240	1100		4	-	-	"			
X		INTERIOR LTG	20	1	5			950	6	-	-	"			
		CU-1	30	2	7	1260		3240	8	50	3	AC-2			
		"	-	-	9		1260		10	-	-	"			
		EF-1	20	1	11			66	12	-	-	"			
X		INTERIOR LTG	20	1	13	1040		3720	14	50	3	AC-3			
		EW-1-CR10	40	1	15		3500		16	-	-	"			
		EW-1-CR10	40	1	17			3720	18	-	-	"			
		EW-1-TOILET	40	1	19	3500			20	50	3	AC-4			
		DISPLAY LTG	20	1	21		200		22	-	-	"			
X		EXTERIOR LTG	20	1	23			465	24	-	-	"			
		EM LTG INVERTER	20	1	25	250			26	20	2	FC-1			
		SPARE	20	1	27	150			28	-	-	"			
		SPARE	20	1	29		150		30	20	1	SPARE			
		SPARE	20	1	31				32	20	1	SPARE			
		SPARE	20	1	33				34	20	1	SPARE			
		SPARE	20	1	35				36	20	1	SPARE			
		PANEL L2	125	3	37	8000			38	200	3	FUTURE PANEL DR			
		"	-	-	39		6300		40	-	-	"			
		"	-	-	41			10800	42	-	-	"			
SPECIAL PANEL								NOTE #1							
NOTE								NOTE #2							
NHL= Non Harmonic Load		TOTAL LOAD PER PHASE		29450		26910		30181		HIGH PHASE		30534.8 / 0.9pf = VA @ 120V		282.7 AMPS	
LCL= Long Continuous Load		25% LONG CONTINUOUS LOADS		473		275		354		ALL PHASES		87642.3 / 0.9pf = VA @ 208V/3PH		270.5 AMPS	
Max. Neut. Load		SUB PANEL								DEMAND PER				AMPS	
428 AMPS		SUB PANEL								NEC 220-34					
		TOTAL CONNECTED LOAD		29923		27185		30535							

M:\Panel Schedule\2019\19030 Sycamore Canyon\L1

8:46 AM 3/16/2020



2

120/208		120/208 3PH, 4WIRE		400 AMP		Main		Breaker <input checked="" type="checkbox"/>		ENCLOSURE TYPE		ENCLOSURE NOTE			
		200% Neutral Bus				Enclosure		Lug <input type="checkbox"/>		<input checked="" type="checkbox"/> NEMA TYPE 1					
		(INTEGRAL)TVSS Protection <input checked="" type="checkbox"/>						Recessed <input type="checkbox"/>		NEMA TYPE 3R					
		(REMOTE)TVSS Protection						Surface <input checked="" type="checkbox"/>		NEMA TYPE 4X					
<b>L2</b>		Service Entrance Rated		GENERAL DISTRIBUTION		PROVIDE LOCK ON BREAKER DEVICES FOR ALL EMERGENCY LIGHTING, MOTORS									
		Load Side Feed thru Lugs		BREAKER REQUIREMENTS :		AND FIRE ALARM EQUIPMENT (DEVICE SHALL BE RED) SERVED FROM THIS PANEL									
LCL	NHL	CIRCUIT DESCRIPTION	AMP	POLE	NO	PHASE A	PHASE B	PHASE C	NO	AMP	POLE	CIRCUIT DESCRIPTION	LCL	NHL	
		ROOFTOP RECEPT.	20	1	1	600			2	20	1	RECEPT CORD REEL -10			
		EXTERIOR RECEPT.	20	1	3	600	800		4	20	1	RECEPT CORD REEL -10			
		RECEPT - 2	20	1	5		600	1000	6	20	1	RECEPT CORD REEL -10			
		RECEPT - 2	20	1	7	1000		600	8	20	1	RECEPT CORD REEL -10			
		RECEPT - 2	20	1	9	600	600		10	20	1	RECEPT CORD REEL -10			
		RECEPT - 2	20	1	11		600	800	12	20	1	RECEPT CORD REEL -10			
		RECEPT - 3,4	20	1	13	600		600	14	20	1	RECEPT CORD REEL -10			
		RECEPT - 3,4	20	1	15	600	400		16	20	1	RECEPT - 10			
		RECEPT - 2	20	1	17		800	400	18	20	1	RECEPT - 10			
		RECEPT - 4	20	1	19	800		600	20	20	1	RECEPT -10			
		RECEPT - 4	20	1	21	400	800		22	20	1	RECEPT - 10			
		RECEPT - 6	20	1	23		400	600	24	20	1	IDF RECEPT.			
		RECEPT - 7	20	1	25	800		1500	26	20	1	IDF RECEPT.			
		RECEPT - 5	20	1	27	1500	400		28	20	1	RECEPT.			
		HAND DRYER	20	1	29		400	1200	30	30	1	IDF RECEPT. - UPS			
		SPARE	20	1	31			3000	32	20	1	LTG CONTROL PANEL			
		SPARE	20	1	33	500			34	20	1	WIRELESS CLOCK			
		SPARE	20	1	35		500		36	20	1	SPARE			
		SPARE	20	1	37				38	20	1	SPARE			
		SPARE	20	1	39				40	20	1	SPARE			
		SPARE	20	1	41				42	20	1	FIRE ALARM EXT. PANEL			
SPECIAL PANEL										NOTE #1					
NOTE										NOTE #2					
NHL= Non Harmonic Load		TOTAL LOAD PER PHASE		8000		6300		10800		HIGH PHASE		10800 / 0.9pf = VA @ 120V		100.0 AMPS	
LCL= Long Continuous Load		25% LONG CONTINUOUS LOADS		0		0		0		ALL PHASES		25100 / 0.9pf = VA @ 208V/3PH		77.5 AMPS	
Max. Neut. Load		SUB PANEL								DEMAND PER				AMPS	
153 AMPS		SUB PANEL								NEC 220-34					
		TOTAL CONNECTED LOAD		8000		6300		10800							

M:\Panel Schedule\2019\19030 Sycamore Canyon\L2

8:47 AM 3/16/2020